

09

AS BUILT

	N.				
	Date				
	N.				
	Date				
	N.				
	Date				
	N.				
	Date				
C	N.	BGA	HAR	DEG	AS BUILT
	Date	95/03/24	95/03/24	95/03/24	ASB
B	N.	XAL	HAR	DEG	CHANGE OF STATUS & GOOD FOR EXECUTION
	Date	94/01/26	94/01/26	94/01/26	GFE
A	N.	XTO	HAR	DEG	ORIGINAL ISSUE
	Date	93/03/08	93/03/08	93/03/08	INF
REV.		ETABLI ESTABLISHED	VERIFIE CHECKED	APPROUVE APPROVED	MODIFICATIONS STAT.

VINH-SON HYDRO-POWER STATION

2 x 40 MVA

CONTRACT N° 12-05/CEG-PC3-PET/01-91

SOCIALIST REPUBLIC OF VIET-NAM
MINISTRY OF ENERGYPETECHIM-POWER COMPANY Nr 3
ENGINEER EDF


LEADER

CEGELEC

FRANCE

ALSTHOM - JEUMONT
CEGELECNEYRPIC
SDEMECHELLE
SCALE

/

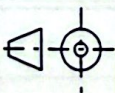GENERAL POWER PLANT
125 VDC & 48 VDC SYSTEM
BATTERIES
ERECTION DRAWING

	DATE	NOM NAME	VISA
ETABLI ESTABLISHED	93/03/08	TOUATI	
VERIFIE CHECKED	93/03/08	HARNAY	
APPROUVE APPROVED	93/03/08	DELAGE	

CEGELEC


Division ERE P : 35, rue d'Alsace F - 92531 Levallois Perret Cedex

CGE VIN00 SLAA-MT001

P2135A40146-C


FOLIO
SHEET
1F*FIN
SH. END
8

Ce document propriété de CEGELEC ne doit pas être utilisé, copié ou communiqué à des tiers sans son autorisation.

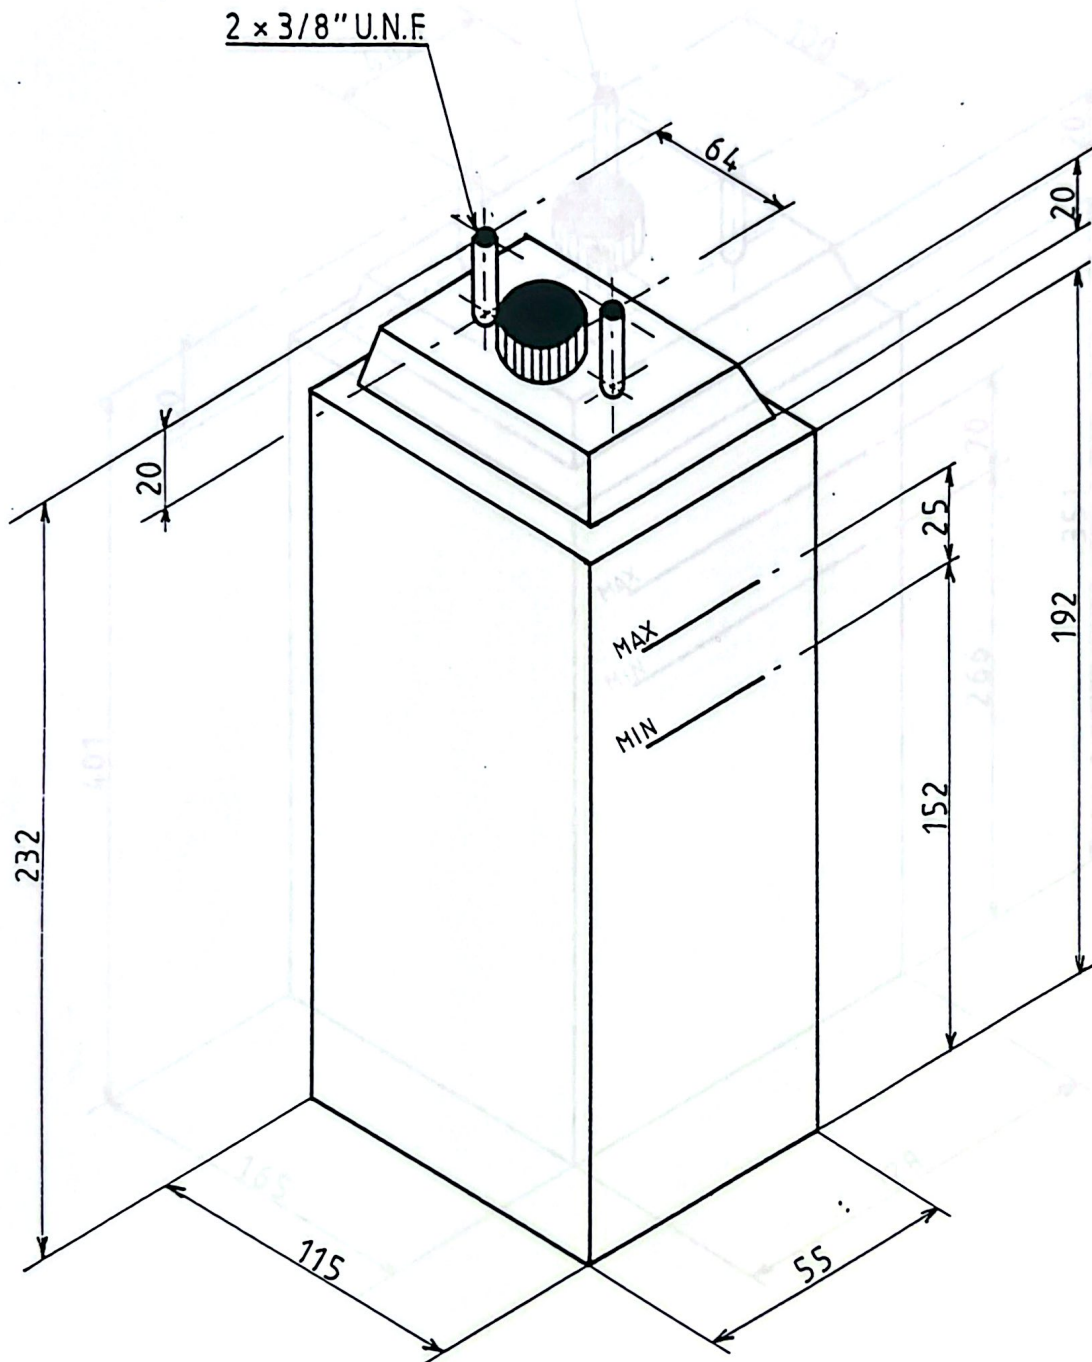


Poids (weight) : 1,50 kg

H			Elément (cell) type : LP 1700		
G					
F					
E					
D			Date :	Nom : <i>S. G.</i>	N°
C			Dossier N°:	Cotes : mm	
B			Echelle		
A					
Ind	Modification	Date	Indice		

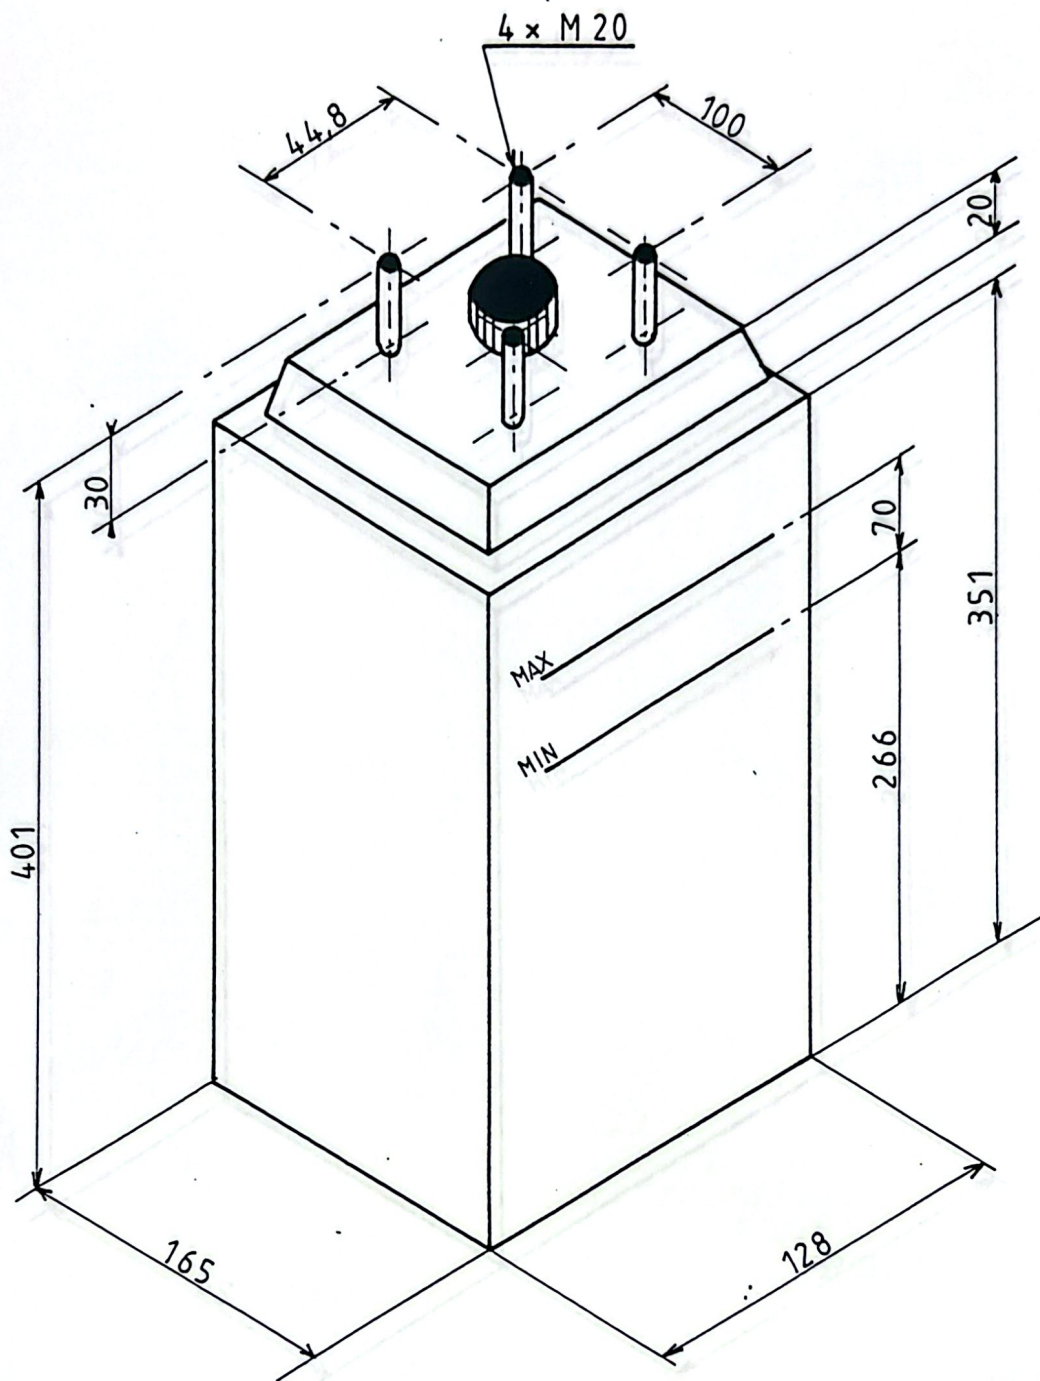


Poids (weight) : 12,60 kg



H			Elément (cell) type: LP 300			
G			Date :	Nom : B. G	N°	
F			Dossier N°:	Cotes: mm		
E			Echelle	TS BATTERIES		
D						
C						
B						
A						
Ind	Modification	Date				Indice

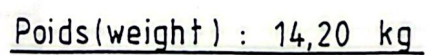

Scanned with
 CamScanner™

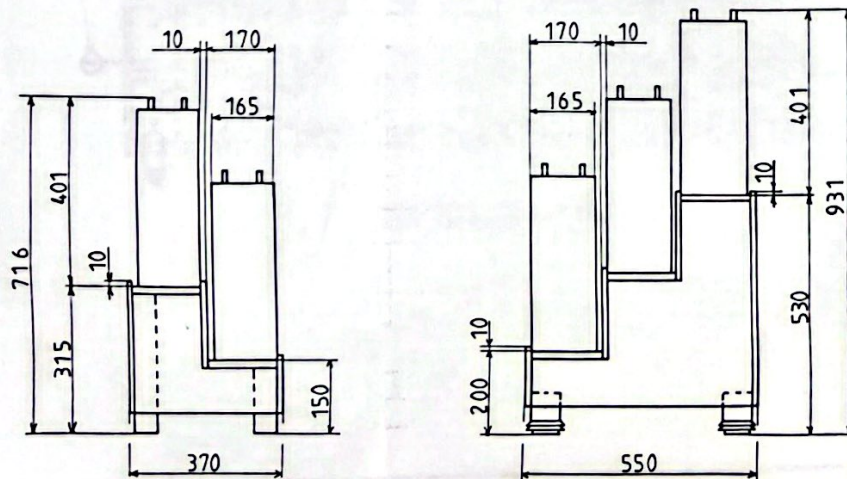

H		
G		
F		
E		
D		
C		
B		
A	LP 200 → LP 300	12-1-5
Ind	Modification	Date

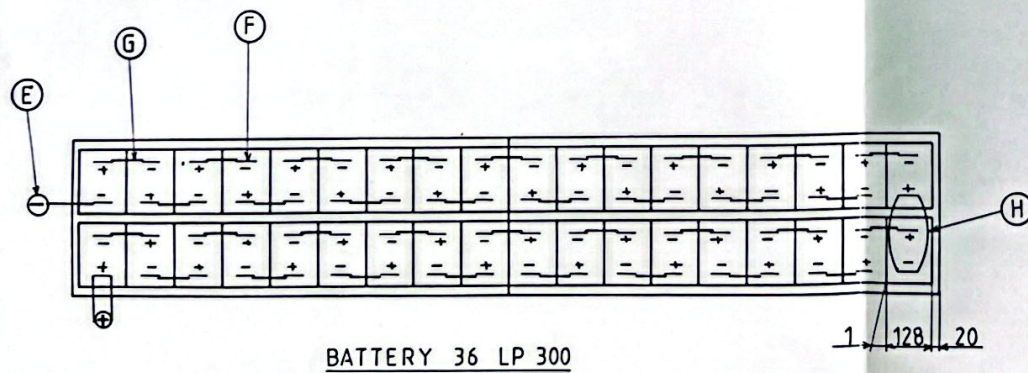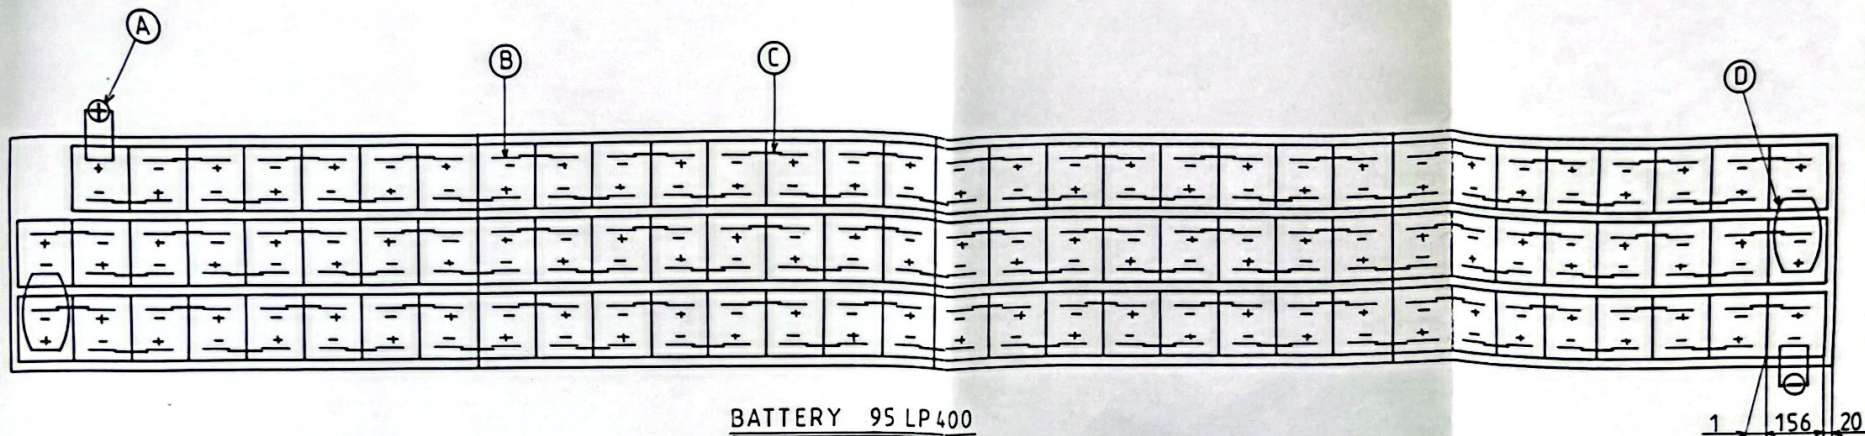

Battery LP 300	H	2	flexibles	connectors length 400	sec. 50 ^e	
	G	34	copper	"	ent. 83 (réf. 39423200 831)	
	F	72	"	"	" 45 (réf. 39423200 451)	
	E	4	end lugs			
Battery LP 400	D	4	flexibles	connectors length 400	sec. 50 ^e	
	C	92	copper	"	ent. 84 (réf. 39423200 841)	
	B	190	"	"	" 74 (réf. 39423200 741)	
	A	4	end lugs			
Rep		Nbr		Désignation		
BATTERIE: Ni Cd			TYPE LP 400	N° D'ELEM 95	CAPACITÉ 400 Ah	INTENSITÉ A
CEGELEC			LP 300	36	300 Ah	A
Aff. Vinh.son			Connector assembly			
Date: 14 - 01 - 93			Nom: 32	N° L 11070 C1		
Dossier N°: 51166			Cotes: mm			
Echelle			BATTERIES			
Date			Indice			