


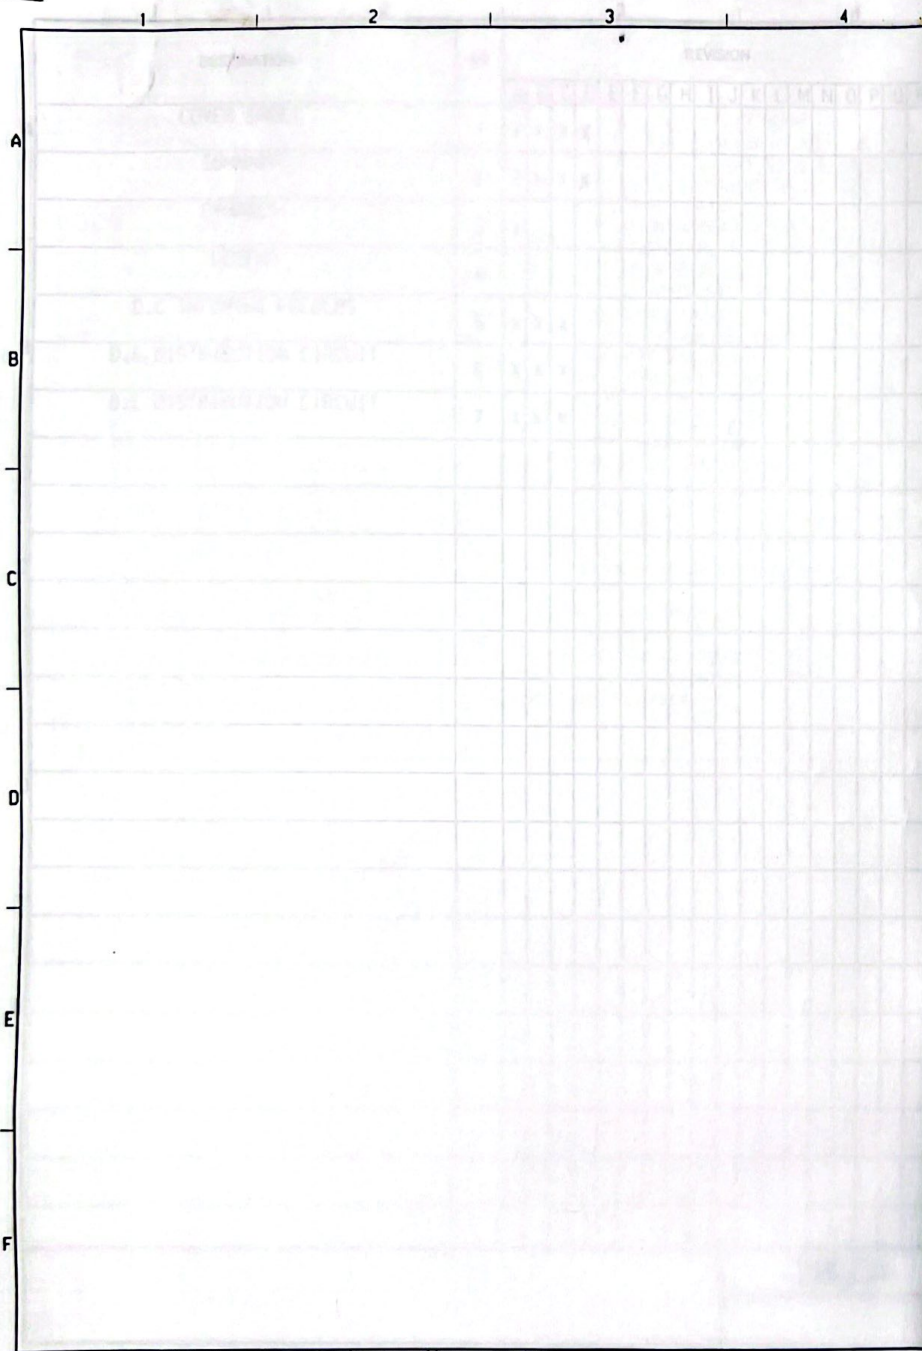

COMMENTS :

09

AS BUILT

N.					
Date					
N.					
Date					
N.					
Date					
D	N. DUR	HAR	DEG	AS BUILT	ASB
	Date 95/08/03	95/08/03	95/08/03		
C	N. XFN	HAR	DEG	UP DATED ACCORDING TO EN209 AND MANUFACTURER DATAS & GOOD FOR EXECUTION	GFE
	Date 93/02/09	93/02/09	93/02/09		
B	N. HUE	HAR	DEG	UP DATED ACCORDING TO CEGELEC STUDIES	APP
	Date 92/12/13	92/12/13	92/12/13		
A	N. HUE	HAR	DEG	ORIGINAL ISSUE	APP
	Date 92/11/13	92/11/13	92/11/13		
REV.	ETABLI	VERIFIE	APPROUVE	MODIFICATIONS	STAT.
	ESTABLISHED	CHECKED	APPROVED		

VINH-SON HYDRO-POWER STATION
2 x 40 MVA
CONTRACT N° 12-05/CEG-PC3-PET/01-91

SOCIALIST REPUBLIC OF VIET-NAM MINISTRY OF ENERGY PETECHIM-POWER COMPANY Nr 3 ENGINEER EDF	LEADER CEGELEC FRANCE ALSTHOM - JEUMONT CEGELEC NEYPIC SDEM
---	---

ECHELLE
SCALE
COMMONS POWER HOUSE
48 VDC SWITCHBOARD
20LCA 001TB
SINGLE LINE DIAGRAM

	DATE	NOM NAME	VISA	▼ CEGELEC Division ERE P : 35, rue d'Alsace F - 92531 Levallois Perret Cedex		
ETABLI ESTABLISHED	92/11/13	HUE				
VERIFIE CHECKED	92/11/13	HAR				
APPROUVE APPROVED	92/11/13	DEG				
CGE	VIN20	SLCA	SU001	P2135A30071-D	FOLIO SHEET 1	F.FIN SHEET 7

ANSI	DESIGNATION	CEI	ANSI	DESIGNATION	CEI
12	OVERSPEED DEVICE	n >	50-76	OVERCURRENT RELAY	I >
13	SYNCHRONOUS-SPEED DEVICE	n c c >	50N	OVERCURRENT RELAY, NEUTRAL	IN >
14	UNDERSPEED DEVICE	n c c >	51	TIME-LAG OVERCURRENT RELAY	I >
15	SPEED MATCHING DEVICE	n c c >	51	INVERSE TIME OVERCURRENT RELAY	I >
21	DISTANCE OR UNDERIMPEDANCE RELAY	z >	51N	TIME-LAG OVERCURRENT RELAY, NEUTRAL	IN >
21	DISTANCE OR UNDERREACTANCE RELAY	x >	51V	TIME-LAG OVERCURRENT RELAY WITH VOLTAGE RESTRAINT	I > U >
21	DISTANCE OR OVERADMITTANCE RELAY	y >			
23	TEMPERATURE CONTROL DEVICE	θ	53	EXCITATION INCREASE RELAY	B >
25	VOLTAGE COMPARISON DEVICE	u >	55	POWER FACTOR RELAY	cos φ
25	PHASE-ANGLE COMPARISON DEVICE	φ >	56	EXCITATION RELAY	B
25	FREQUENCY COMPARISON DEVICE	f >	58	RECTIFICATION FAILURE RELAY	D = 0
25	COUPLING DEVICE	↑	59	OVERVOLTAGE RELAY	U >
25	SYNCHRONIZING OR SYNCHRONISM-CHECK DEVICE	uf >	59N	NEUTRAL OVERVOLTAGE RELAY	UN >
26	THERMOMETER DETECTOR	θ	59-81	OVERINDUCTION RELAY	U / f >
27	UNDERVOLTAGE RELAY	u >	60	VOLTAGE BALANCE RELAY	U d
27	NO-VOLTAGE RELAY	u = 0	60	CURRENT BALANCE	I d
30	ANNUNCIATOR RELAY	⊙	63	PRESSURE SWITCH	P
32	DIRECTIONAL ACTIVE POWER RELAY	⊙	64	FRAME LEAKAGE RELAY	T
32	DIRECTIONAL REACTIVE POWER RELAY	⊙	67	DIRECTIONAL OVERCURRENT RELAY	I IN
32	REVERSE ACTIVE POWER RELAY	⊙	67N	DIRECTIONAL HOMOPOLAR OVERCURRENT RELAY	I IN
32	REVERSE REACTIVE POWER RELAY	⊙	71	LEVEL SWITCH	⊕
37	UNDERCURRENT RELAY	p >	74	ALARM RELAY	⊕
37	UNDER POWER RELAY	p >	78	MEASURING RELAY AND PHASE-ANGLE PROTECTION	φ >
39	MECHANICAL CONDITION MONITOR	⊕	79	RECLOSING RELAY	⊕
40	EXCITATION FAULT RELAY	B >	81	FREQUENCY RELAY	f >
40	NO-EXCITATION RELAY	B = 0	87	DIFFERENTIAL PROTECTIVE RELAY	Δ I
46	PHASE-BALANCE OR REVERSE-PHASE CURRENT RELAY	I >	87N	DIFFERENTIAL PROTECTIVE RELAY	Δ I
47	VOLTAGE RELAY	u >	95	BUCHHOLZ RELAY	⊕
49	THERMAL RELAY	θ			
49	THERMOSTAT	θ			


5	6	7	8
SWITCH	RESIDUAL CURRENT TRANSFORMER	CAPACITOR	MANUALLY OPERATED
DISCONNECTOR	SHUNT	CAPACITOR VOLTAGE DIVIDER	ELECTROMAGNETIC ACTUATOR
CIRCUIT BREAKER	INDICATING INSTRUMENT	INDUCTOR WINDING	PNEUMATIC OR HYDRAULIC CONTROL
CONTACTOR	RECORDING INSTRUMENT	BATTERY	REVERSER
CONTACTOR POLE (contact closed in the unoperated position)	ENERGY METER	CONVERTER OR MEASURING TRANSDUC.	KEY ALWAYS FREE
SWITCH DISCONNECTOR POLE (on load isolating switch)	IMPULSE COUNTER	RECTIFIER	KEY FREE FOR THE POSITION IN THE DIAGRAM
FUSE	MEASURING RELAY OR RELATED DEVICE	PLUG AND SOCKET	KEY IMPRISONED FOR THE POSITION IN THE DIAGRAM
THERMAL EFFECT MAGNETIC EFFECT	SIGNAL LAMP	ELECTRICAL CONTROL	ISOLATED PHASE BUS DUCT
THREE WAYS SWITCH	LIMITER	LINK	CABLE
ROTATING MACHINE	DOUBLE DISCONNECTOR	INVERTER	OVERHEAD LINE
TRANSFORMER WITH 2 WINDINGS	SPARK GAP	EARTH MASS	CARRIER LINE TRAP
TRANSFORMER WITH 3 WINDINGS	LIGHTNING ARRESTER	PULSE	PLUG (male)
AUTO-TRANSFORMER	RESISTOR	MECHANICAL INTERLOCK	SOCKET (female)
CURRENT TRANSFORMER	VARIABLE RESISTOR	KEY OPERATED	POWER LINE CARRIER COUPLING DEVICE

DESIGNATION	TYPE	ACTUATOR	POWER
DESIGNATION 1	TYPE	ACTUATOR	POWER
DESIGNATION 2	TYPE	ACTUATOR	POWER
DESIGNATION 3	TYPE	ACTUATOR	POWER
DESIGNATION 100	TYPE	ACTUATOR	POWER

DESIGNATION	TYPE	ACTUATOR	POWER
DESIGNATION 1	TYPE	ACTUATOR	POWER
DESIGNATION 2	TYPE	ACTUATOR	POWER
DESIGNATION 3	TYPE	ACTUATOR	POWER
DESIGNATION 100	TYPE	ACTUATOR	POWER

Ce document propriété de CEGELEC ne doit pas être utilisé, copié ou communiqué à des tiers sans son autorisation

20LCA00134

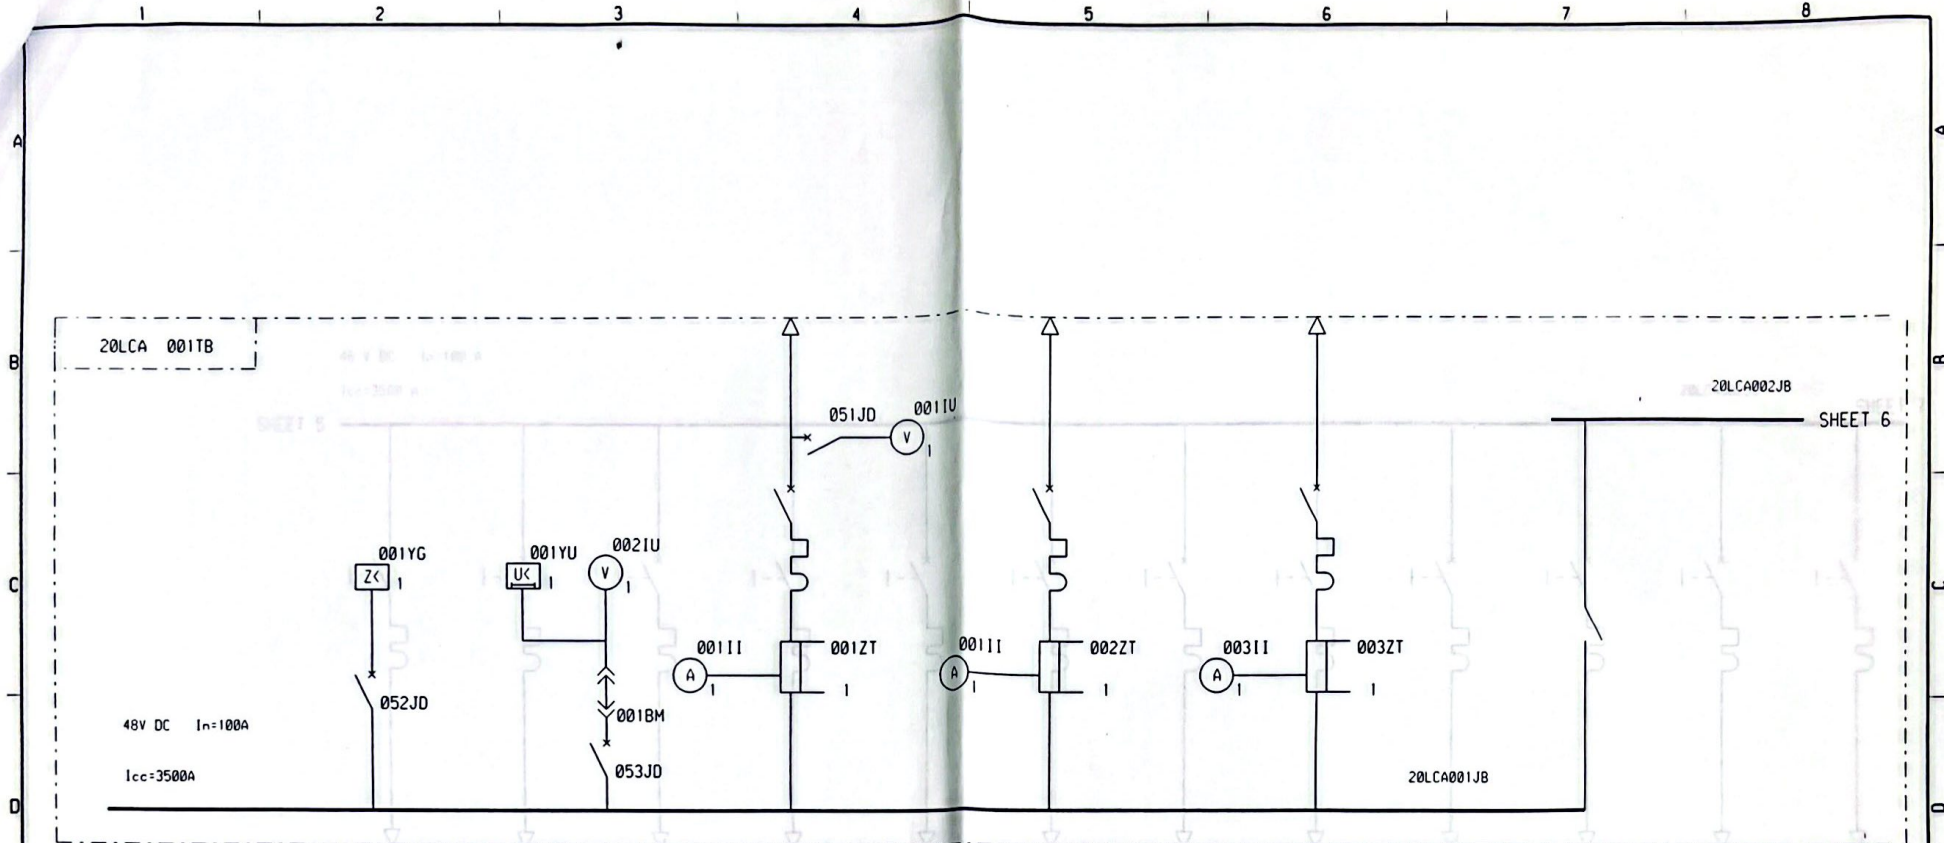

GEOGRAPHICAL ITEM	01A	01A	01F	01G	01H	01E
TYPE	D100	D100	D160	D125	D125	J100
ACTUATOR ITEM	20LCA 000JD	20LCA 000JD	20LCA 001JD	20LCA 002JD	20LCA 003JD	20LCA 004JI
POWER	500 W	500 W	300 Ah	4800 W	4800 W	500 W
DESIGNATION 1 DESIGNATION 2 DESIGNATION 3 TYPICAL DIAGRAM REFERENCE	PERMANENT INSULATED CONTROLLER SHEET 7,14,15,18,19	BUS BARS UNDERVOLTAGE RELAY AND MEASURING SHEET 11	FROM BATTERY 300 Ah 48 V DC SHEET 9	FROM CHARGER RECTIFIER 48V DC NUMBER 1 SHEET 8	FROM CHARGER RECTIFIER 48V DC NUMBER 2 SHEET 8	BUS BARS COUPLING SWITCH SHEET 10
CONSUMER ITEM	20LCA 001TB	20LCA 001TB	20LCA 001TB	20LCA 001RD	20LCA 002RD	20LCA 003RD

20LCA 001TB


48 V DC In=100 A

Icc=3500 A

20LCA002JB

SHEET 7

SHEET 5

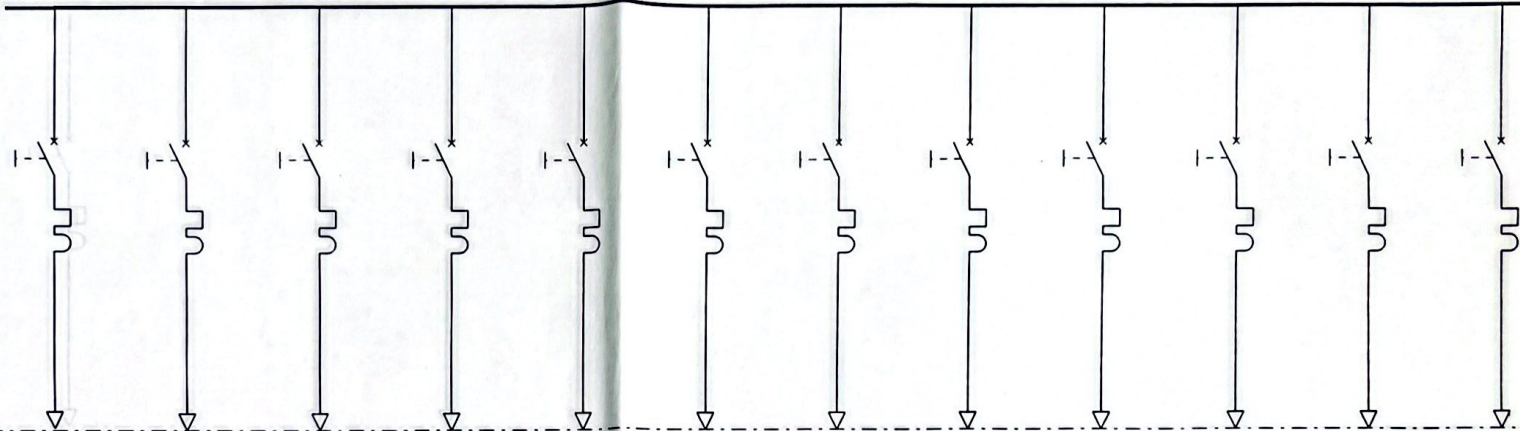

	GEOGRAPHICAL ITEM	02A1	02A2	02A3	02C1	02C2	02C3	02E1	02E2	02E3	02G1	02G2	02G3	
	TYPE	D100	D100	D100	D100	D100	D100	D100	D100	D100	D100	D100	D100	
	ACTUATOR ITEM	20LCA 005JD	20LCA 006JD	20LCA 007JD	20LCA 008JD	20LCA 009JD	20LCA 010JD	20LCA 011JD	20LCA 012JD	20LCA 013JD	20LCA 014JD	20LCA 015JD	20LCA 016JD	
	POWER	541 W	740 W	175 W	223 W	23 W	33 W	230 W	541 W	45 W	70 W	70 W	154 W	
E	DESIGNATION 1 DESIGNATION 2 DESIGNATION 3 TYPICAL DIAGRAM REFERENCE CCEVIN00SLCA-ST001	UNIT 1 CONTROL PANEL SHEET 11	AUXIL. RELAYING PROTECTION PANEL SHEET 11	VENTILATION SHEET 11	AIR CONDITIONING SHEET 11	SERVICE WATER LOCAL CONTROL BOX SHEET 11	TRANSFORMER FIRE PROTECTION LOCAL CONTROL BOX SHEET 11	HYDRAULIC MEASURES PANEL SHEET 11	UNIT 2 CONTROL PANEL SHEET 11	SWITCHYARD CONTROL PANEL COUPLING SHEET 11	SWITCHYARD CONTROL PANEL LINE 1 SHEET 11	SWITCHYARD CONTROL PANEL LINE 2 SHEET 11	SWITCHYARD CONTROL PANEL BUS BARS SHEET 11	
F	CONSUMER ITEM	01GTA 001TD	00KKL 001TD	200VM 001CR	200VL 001CR	20SE1 001CR	20JPT 001CR	00KMH 001TD	02GTA 001TD	60LRC 001TD	61LRL 001TD	62LRL 001TD	60LRC 001TD	
					20LCA		DISTRIBUTION CIRCUITS 48 V DC				Division ERE P			
					001TB		SINGLE LINE DIAGRAM				P2135A30071 c		FOLD SHEET 6	VOR SHEET 7

Ce document propriété de CEGELEC ne doit pas être utilisé, copié ou communiqué à des tiers sans son autorisation.

8 FENL2LE134


20LCA 001TB

48 V DC In=100 A

Icc=3500 A

20LCA002JB

SHEET 6

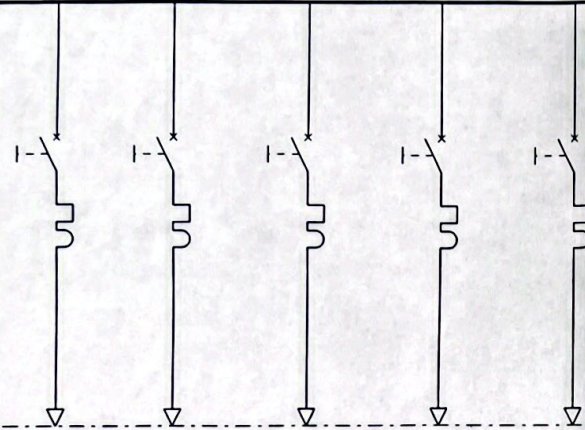

GEOGRAPHICAL ITEM	0211	0212	0213	02A4	02C4										
TYPE	D100	D100	D100	D100	D100										
ACTUATOR ITEM	20LCA 017JD	20LCA 018JD	20LCA 019JD	20LCA 020JD	20LCA 021JD										
POWER	50 W	50 W	30 W												
DESIGNATION 1 DESIGNATION 2 DESIGNATION 3 TYPICAL DIAGRAM REFERENCE CGEV IN00SLCA-ST001	FIRE PROTECTION CONTROL PANEL TR UNIT 1 SHEET 11	FIRE PROTECTION CONTROL PANEL TR UNIT 2 SHEET 11	AUXILIARY RELAYING PROTECTION PANEL FOR 20LCA SHEET 11	EQUIPPED SPARE SHEET 11	EQUIPPED SPARE SHEET 11										
CONSUMER ITEM	01JPT 001CR	02JPT 001CR	00KKL 001TD												
				20LCA	DISTRIBUTION CIRCUITS				Division				ERE P		
				001TB	48 V DC				CEGELEC				P2135A30071 c		
					SINGLE LINE DIAGRAM								FOLD SHEET 7		

Ce document propriété de CEGELEC ne doit pas être utilisé, copié ou communiqué à des tiers sans son autorisation

XENL2LE1341